

# Certificate of Compliance

**Certificate:** 1113894 (LR 27991-44)

**Master Contract:** 150014

**Project:** 1421204

**Date Issued:** May 12, 2003


**Issued to:** ADALET-PLM  
4801 W. 150 th St.  
Cleveland OH 44135  
USA

**Attention:** Mr. Timothy Snelly


*The products listed below are eligible to bear the CSA Mark shown*



**Issued by:**

  
D. Somma, C.E.T.

**Authorized by:**

  
Nick Alfano  
Operations Manager

## PRODUCTS

CLASS 4418 03 - CONDUIT FITTINGS - Fittings For Metal Conduit - For Hazardous Locations

### **Class I, Groups C and D:**

Conduit fitting for draining and venting Cat. No. XFA-2, ½ in trade size.

### **Class I, Groups B, C and D:**

Conduit fitting for draining and venting Cat. No. XFAX-2, ½ in trade size.

## APPLICABLE REQUIREMENTS

CSA Standard C22.2 No. 0.5-1979 - Threaded Conduit Entries

CSA Standard C22.2 No. 30-M1986 - Explosion-Proof Enclosures for Use in Class I Hazardous Locations

## MARKINGS

The head of each fitting is metal stamped with: Submitter's Name, Cat. No. Designation, Hazardous Location Designation and the CSA Monogram



CSA INTERNATIONAL

## *Supplement to Certificate of Compliance*

**Certificate:** 1113894 (LR27991-44)

**Master Contract:** 150014

*The products listed, including the latest revision described below,  
are eligible to be marked in accordance with the referenced Certificate.*

### **Product Certification History**

---

<b>Project</b>	<b>Date</b>	<b>Description</b>
1421204	May 12, 2003	Addition of alternate Manufacturer of sintered element.
1150567	Feb. 7, 2001	Update to add flame arrestor fitting model XFAX-2 for Class I, Groups B, C and D.
1113894	July 31, 2000	Update to add new model XFAX-2 and to change drawings.
-44	Feb. 7, 1990	Original Certification



# Descriptive and Test Report

**MASTER CONTRACT:** 150014  
**REPORT:** 1113894 (LR 27991-44)  
**PROJECT:** 1421204

**Edition 1:** February 7, 1990; Application No LR 27991-44 – Toronto  
Issued by D. Somma, CET

**Edition 2:** July 31, 2000; Project 1113894 - Toronto  
Issued by D. Somma, CET

Report Pages Reissued

**Edition 3:** February 7, 2001; Project 1150567 - Toronto  
Issued by Ezio Migliozi; Reviewed by D. Somma, CET

Report Pages Reissued  
Attachments Added: Appendix I (Kept in Engineering File Only)

**Edition 4:** May 12, 2003; Project 1421204 - Toronto  
Issued by D. Somma, C.E.T.

Report Pages Reissued  
Drawings Updated: 6124, 20338  
Replaced Drawing: 20336 replaces 6126

Contents: Certificate of Compliance - Page 1  
Supplement to Certificate of Compliance - Page 1  
Description and Tests - Pages 1 to 5  
Fig. 1 – UL report File E 10493  
Descriptive Document Drawings ( Drawing Nos.: 6124, 20336, 7887, 20338)  
Attachments - Appendix I (Kept in Engineering File Only)

## **PRODUCTS**

**CLASS 4418 03 - CONDUIT FITTINGS - Fittings For Metal Conduit - For Hazardous Locations**

### **Class I, Groups C and D:**

Conduit fitting for draining and venting Cat. No. XFA-2, ½ in trade size.

### **Class I, Groups B, C and D:**

Conduit fitting for draining and venting Cat. No. XFAX-2, ½ in trade size

The test report shall not be reproduced, except in full, without the approval of CSA International.

178 Rexdale Boulevard, Toronto, ON, Canada M9W 1R3

Telephone: 416.747.4000 1.800.463.6727 Fax: 416.747.4149 [www.csa-international.org](http://www.csa-international.org)

**APPLICABLE REQUIREMENTS**

CSA Standard C22.2 No. 0.5-1979 - Threaded Conduit Entries  
CSA Standard C22.2 No. 30-M1986 - Explosion-Proof Enclosures for Use in Class I Hazardous Locations

**MARKINGS**

The head of each fitting is metal stamped with: Submitter's Name, Cat. No. Designation, Hazardous Location Designation and the CSA Monogram.

**ALTERATIONS**

Markings as stated above.

**FACTORY TESTS**

None required.

**DESCRIPTION**

**Part A - Model XFA-2**

**General:** The submitter provided a copy in a form of UL report file E10493, issued September 19, 1988 describing the subject fitting. Attached as Fig 1. The submitter also provided updated drawings of the construction of the subject fitting not covered under the mentioned UL file.

**Construction:** Updated drawings Nos 20336 and 6124 illustrate the present construction, supercedes the same Drawing Nos attached in the UL report.

**Part B- Model XFAX-2**

**General:** The construction is the same as the model XFA-2, except the length of the flame arrestor element was increased from .375" to .500" and the snap ring location in the body of the fitting was moved to accommodate the longer element.

**Descriptive Documents Flame Arrestors Cat. Nos. XFA-2 & XFAX-2:**

<u>Subject</u>	<u>Drawing</u>	<u>Rev.</u>	<u>Date</u>
SS Sintered Element	6124	G	02/25/03
XFA-2 Flame Arrestor Assembly	20336	N	02/28/03
Bulkhead fitting body for flame arrester	7887	B	04/18/00
XFAX-2 Bulkhead fitting body for flame arrester	20338	D	02/28/03

## TEST REPORT

In addition to the test performed by UL a representative sample Cat No XFA-2 was subjected to the following test:

1. Explosion Flame Propagation Test: Std 30-M1986 Cl 6.5.4 (c)

Class I, Group C - 37 +/- 0.5 percent hydrogen mixed with air five (5) trials were performed: Max Expl. pressure recorded 95 psi.

Results: There was no external mixture ignition. Satisfactory.

In view of the above, no further tests were deemed necessary.

Project 1113894: Additional test was not requested due to the flame path was increased creating a margin of safety for preventing the transmission of flame.

Project 1150567: Tests were performed by CSA Laboratory and detail Test Data is attached under Appendix I, (Kept in Eng. File only).

Summary of the Tests are as follows:

A sample of model XFAX2 flame arrester (1/2 in Trade Size) was subjected to the following Tests:

1. Overpressure Test: CSA C22.2 No.30, Clause 6.11

A 8000 kPa (1160 psi) pressure was applied for 1 min.

Result: Satisfactory.

2. Explosion Flame Propagation Test for Flame Arrestors: CSA C22.2 No. 30, Clause 6.5.4

The sample was installed in the outer wall of the test enclosure and submitted to 5 shots of a mixture 40.0% Hydrogen and 20% Oxygen.

Result: No propagation. Satisfactory.

No further tests were considered necessary

**Project No. 1421204:** This Project covers the addition of alternate manufacturer of Sintered Element that is incorporated into the flame arrestor fittings. The sintered element has the same characteristics as the one that is currently used. The manufacturer of the sintered element tested the sintered element according to ISO Standard 4003:1977 ( Determination of Bubble Test Pore Size); ISO Standard 4022:1973(Fluid Permeability) and ISO Standard 2738:1987( Density and open Porosity). Records are kept in the correspondence file. In View of the above the only test deemed necessary was as follows:

One sample of Cat. No. XFA-2 (Cl. I, Gr. C & D) was subjected to a Hydrostatic Overpressure of 600 psig/min

One sample of Cat. No. XFAX-2 (Cl. I, Gr. B, C & D) was subjected to a Hydrostatic Overpressure of 1160 psig/min.


Results: Satisfactory

**NOTES:**

1. MISSING MATERIAL MAY NOT EXCEED .063 x .032 x .032 ON ANY EXTERNAL SURFACE (1.6mm)x(.8mm)x(.8mm)
2. VENDOR: **MOTT METAL CO. (CONN.)**  
ALTERNATE VENDOR: **CHAND METALLURGICAL**
3. SUPPLIED WITH EACH ORDER:  
CERTIFICATE OF CONFORMITY PER ANNEX B OF STANDARD EN 50018 FOR PART #6124--1 FOR DETERMINATION OF:
  - A) EQUIVALENT BUBBLE TEST PORE SIZE BY METHOD SPECIFIED IN ISO STANDARD 4003.
  - B) DENSITY OF SINTERED ELEMENT IN ACCORDANCE WITH ISO STANDARD 2738.
  - C) DETERMINATION OF OPEN POROSITY AND/OR FLUID PERMEABILITY IN ACCORDANCE WITH ISO STANDARD 2738 AND 4022.

4. PURCHASE MOTT STANDARD PART WITH .377±.005 DIA. SORT IN HOUSE TO DIA. SHOWN.

*Certificate No. 1113894*  
*Project No. 1421204*  
*Partic Number: 159014*

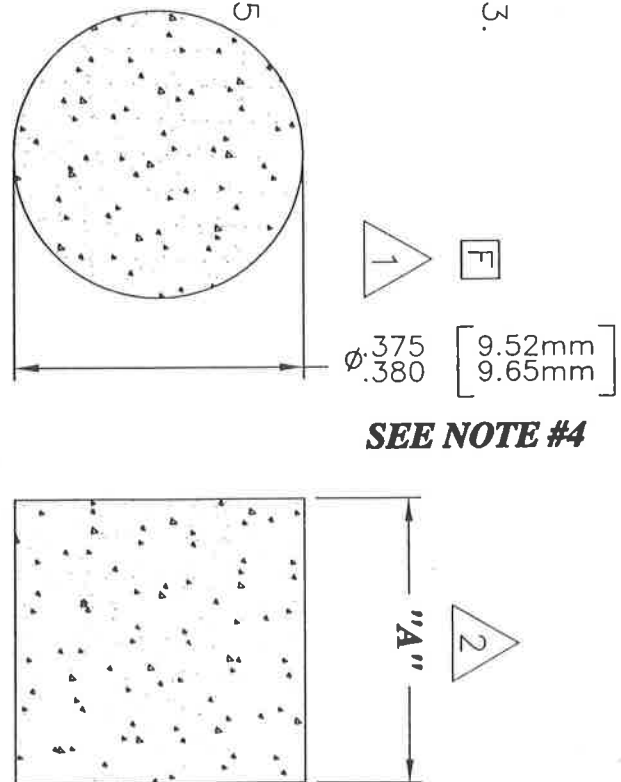


**PART IDENTIFICATION TABLE**

PART #	"A"	MOTT PART #	CHAND PART #
6124	.375(9.5MM)	1043982-01-999	CMS--.375--.375-100
6124-1	.500(12.7MM)	1500S-.377-.500-100	CMS--.375--.500-100

DO NOT SCALE DRAWING UNLESS OTHERWISE SPECIFIED. DIMENSIONS ARE IN INCHES.		MAKEING TOLERANCES ON DIMENSIONS NOT OTHERWISE SPECIFIED: .125" .005" .01" .005" .015" R. or AS	
GAST TOLERANCES ON DIMENSIONS NOT OTHERWISE SPECIFIED: .125" .005" .01" .005" .015" R. or AS		GROUND FOR THREADED HOLES NOT OTHERWISE SPECIFIED: .125" .005" .01" .005" .015" R. or AS	
FILE 1/8 STOCK FILE 1/8 CORNER RUM 1/8"		NOTE TO PERSONS REGARDING THE DRAWING: THIS DRAWING IS THE PROPERTY OF SCOTT FITZGER COMPANY AND IS NOT TO BE REPRODUCED OR USED TO MANUFACTURE ANYTHING WITHOUT WRITTEN PERMISSION FROM MARKET-PLA TO THE USER.	
TITLE: SS SINTERED ELEMENT		DRAWN BY: MAD DATE: 02/23/00	
MATERIAL: 316 SS 100 MICRON FINISH: NATURAL		KING APPROVAL: 3/3/03 DATE: 3/3/03	
CAT NO: N/A		DRG APPROVAL: 6124 DATE: 10F1	
PART NO: 6124		REV: 10F1 G	



REV	REVISION	BY	ECN	DATE
L	REVISE & RE-RAVN TO CAD	KM	3075	1/11/96
M	UPDATED B.O.M. UPDATED TITLE DESCRIPTION	GM	7159	1/31/03
N	ADDED CHAND (ALTERNATE VENDOR FOR SINTERED ELEMENT)	MM	7166	2/26/03

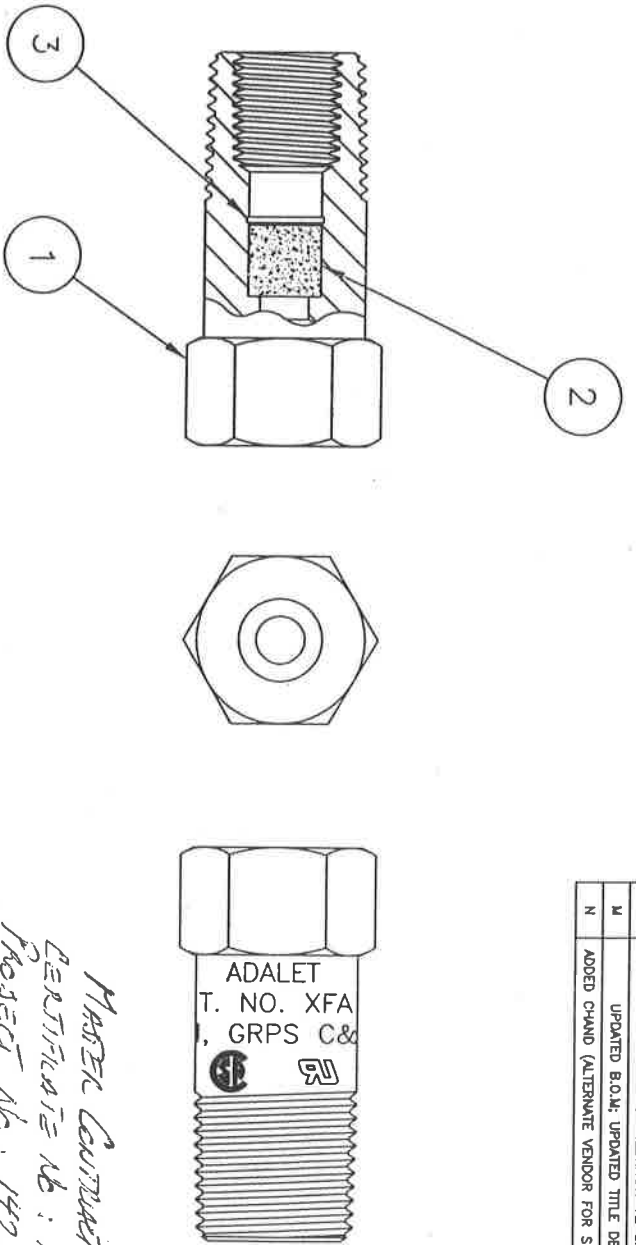

### BILL OF MATERIAL

ITEM #	QTY.	PART #	DESCRIPTION
1	1	6126	XFA-2 BODY (303 SS)
2	CHOOSE	6124	SINTERED ELEMENT MOTT #1043982-01-999
3	1	5191-3	SINTERED ELEMENT CHAND #CMS-.375-.375-100
			RETAINING RING N5000-37H

DO NOT SCALE DRAWING  
 DIMENSIONS OPERATING DIMENSIONS UNLESS OTHERWISE SPECIFIED  
 DIMENSIONS ARE IN INCHES  
 CLIP TO LEADING EDGE OF DIMENSIONS  
 NOT OPERATING SPECIFIED  
 1/8" STOCK  
 FILET OR CORNER RADIUS 1/8"  
 FINISH 1/16"  
 ANGLES ± 1°

PLACING TOLERANCES ON DIMENSIONS NOT OPERATING SPECIFIED:  
 F = 1/25" ± .03"  
 XX ± .03"  
 XXX ± .010"  
 FILET RADIUS .03"  
 HOLE BORE .005" - .015" R. or 45°  
 CHAMFER ± .005" ± .005"  
 NOT OPERATING SPECIFIED DIMENSIONS  
 HP-2M E-24-1.0


NOTICE TO PERSONS RECEIVING THIS DRAWING:  
 ADULT-FILM CLAIMS PROPRIETARY RIGHTS IN THE MATERIAL  
 REPRODUCED HEREON. THIS DRAWING IS ISSUED IN CONFORMANCE  
 WITH THE PATENT RIGHTS OF THE SCOTT FELTZER COMPANY.  
 NO REPRODUCTION OR TRANSMISSION OF THIS DRAWING OR ANY PART  
 THEREOF IS PERMITTED WITHOUT THE WRITTEN PERMISSION FROM ADULT-FILM  
 IN THE USA.

**ADALET**  
 A SCOTT FELTZER COMPANY  
 Enclosure Systems • Cable Accessories

TITLE: XFA-2 FLAME ARRESTOR ASSEMBLY  
 MATERIAL: XFA-2  
 DATE NO: XFA-2

DESIGN BY: KM DATE: 1/11/96  
 END APPROVAL: KM DATE: 1/11/96  
 DWG NO: 20336  
 DWG SIZE: 10F1  
 REV: N

REV	REVISION	BY	ECN	DATE
B	REVISE DEMO MARKING	AMM	5893	04/18/00
C	ADDED GROUP B	DJM	6214	2/9/01
D	ADDED CHAND (ALTERNATE VENDOR FOR SINTERED ELEMENT)	AMM	7186	2/28/03

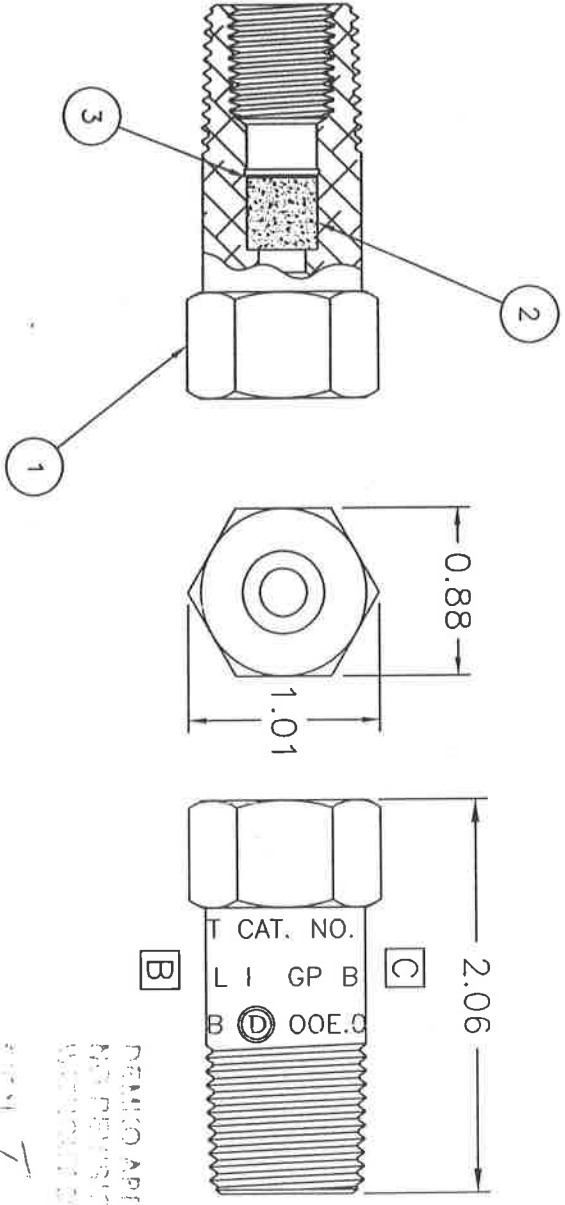

DEMAND APPROVED  
 NOT REVISION TO DRAWING  
 WITHOUT DEMAND APPROVAL  
 3/11/03

MASTER COPY: 153814  
 CENTERLINE: 111589  
 INDEX NO: 1421204

## BILL OF MATERIAL

ITEM #	QTY.	PART #	DESCRIPTION
1	1	7887	XFAX2 BODY FLAME ARRESTER CENELEC
2	CHOOSE	6124-1	SINTERED ELEMENT MOTT #1500S-.377-.500-100
3	1	5191-3	SINTERED ELEMENT CHAND #CMS-.375-.500-100
			RETAINING RING N5000-37H

DO NOT SCALE DRAWING UNLESS OTHERWISE SPECIFIED DIMENSIONS ARE IN INCHES. CAST TOLERANCES ON DIMENSIONS NOT OTHERWISE SPECIFIED: FINE 1/32" MEDIUM 1/16" COARSE 1/8"	MACHINE TOLERANCES ON DIMENSIONS UNLESS OTHERWISE SPECIFIED: FINE 1/32" MEDIUM 1/16" COARSE 1/8"	TITLE <b>ADALTEC</b> A SCOTT FETZER COMPANY Enclosure Systems - Cable Accessories CENELEC BULKHEAD FITTING BODY FOR FLAME ARRESTOR ASSEMBLY	DRAWN BY AMM DATE 03-17-00
NOT TO SCALE DRAWING UNLESS OTHERWISE SPECIFIED DIMENSIONS ARE IN INCHES. CAST TOLERANCES ON DIMENSIONS NOT OTHERWISE SPECIFIED: FINE 1/32" MEDIUM 1/16" COARSE 1/8"	MACHINE TOLERANCES ON DIMENSIONS UNLESS OTHERWISE SPECIFIED: FINE 1/32" MEDIUM 1/16" COARSE 1/8"	TITLE <b>ADALTEC</b> A SCOTT FETZER COMPANY Enclosure Systems - Cable Accessories CENELEC BULKHEAD FITTING BODY FOR FLAME ARRESTOR ASSEMBLY	DRAWN BY AMM DATE 03-17-00
NOTICE TO PERSONS RECEIVING THIS DRAWING: ADALTEC-PLI CLAIM PROPRIETARY RIGHTS IN THE MATERIAL DISCLOSED HEREIN. THIS DRAWING IS ISSUED IN CONFIDENCE AND IS NOT TO BE REPRODUCED OR USED FOR ANY OTHER PURPOSE WITHOUT PERMISSION FROM ADALTEC-PLI TO THE USER.	DRAWING APPROVAL DATE APPROVAL 3/13/03	PLOT SCALE 1=1	DATE 03-17-00
CAT NO XFAX2	PART NO XFAX2	SHEET 10F1	REV D